



PLAN
Scale 1:2500

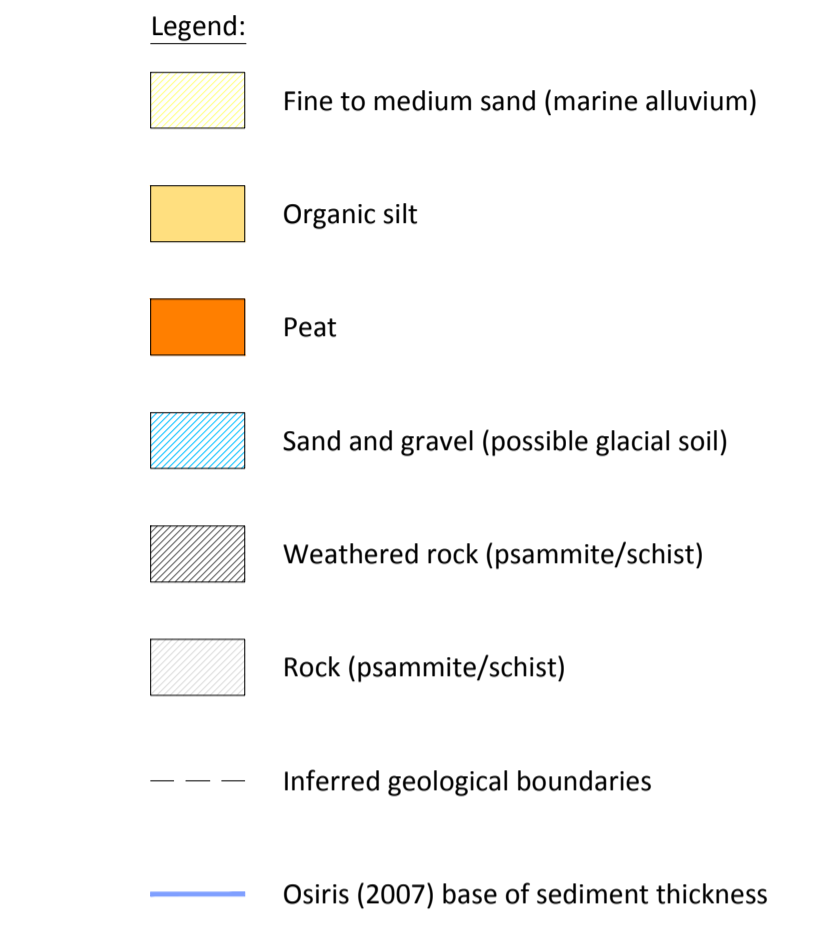

FOR INFORMATION

Applied Ground Engineering Consultants Limited

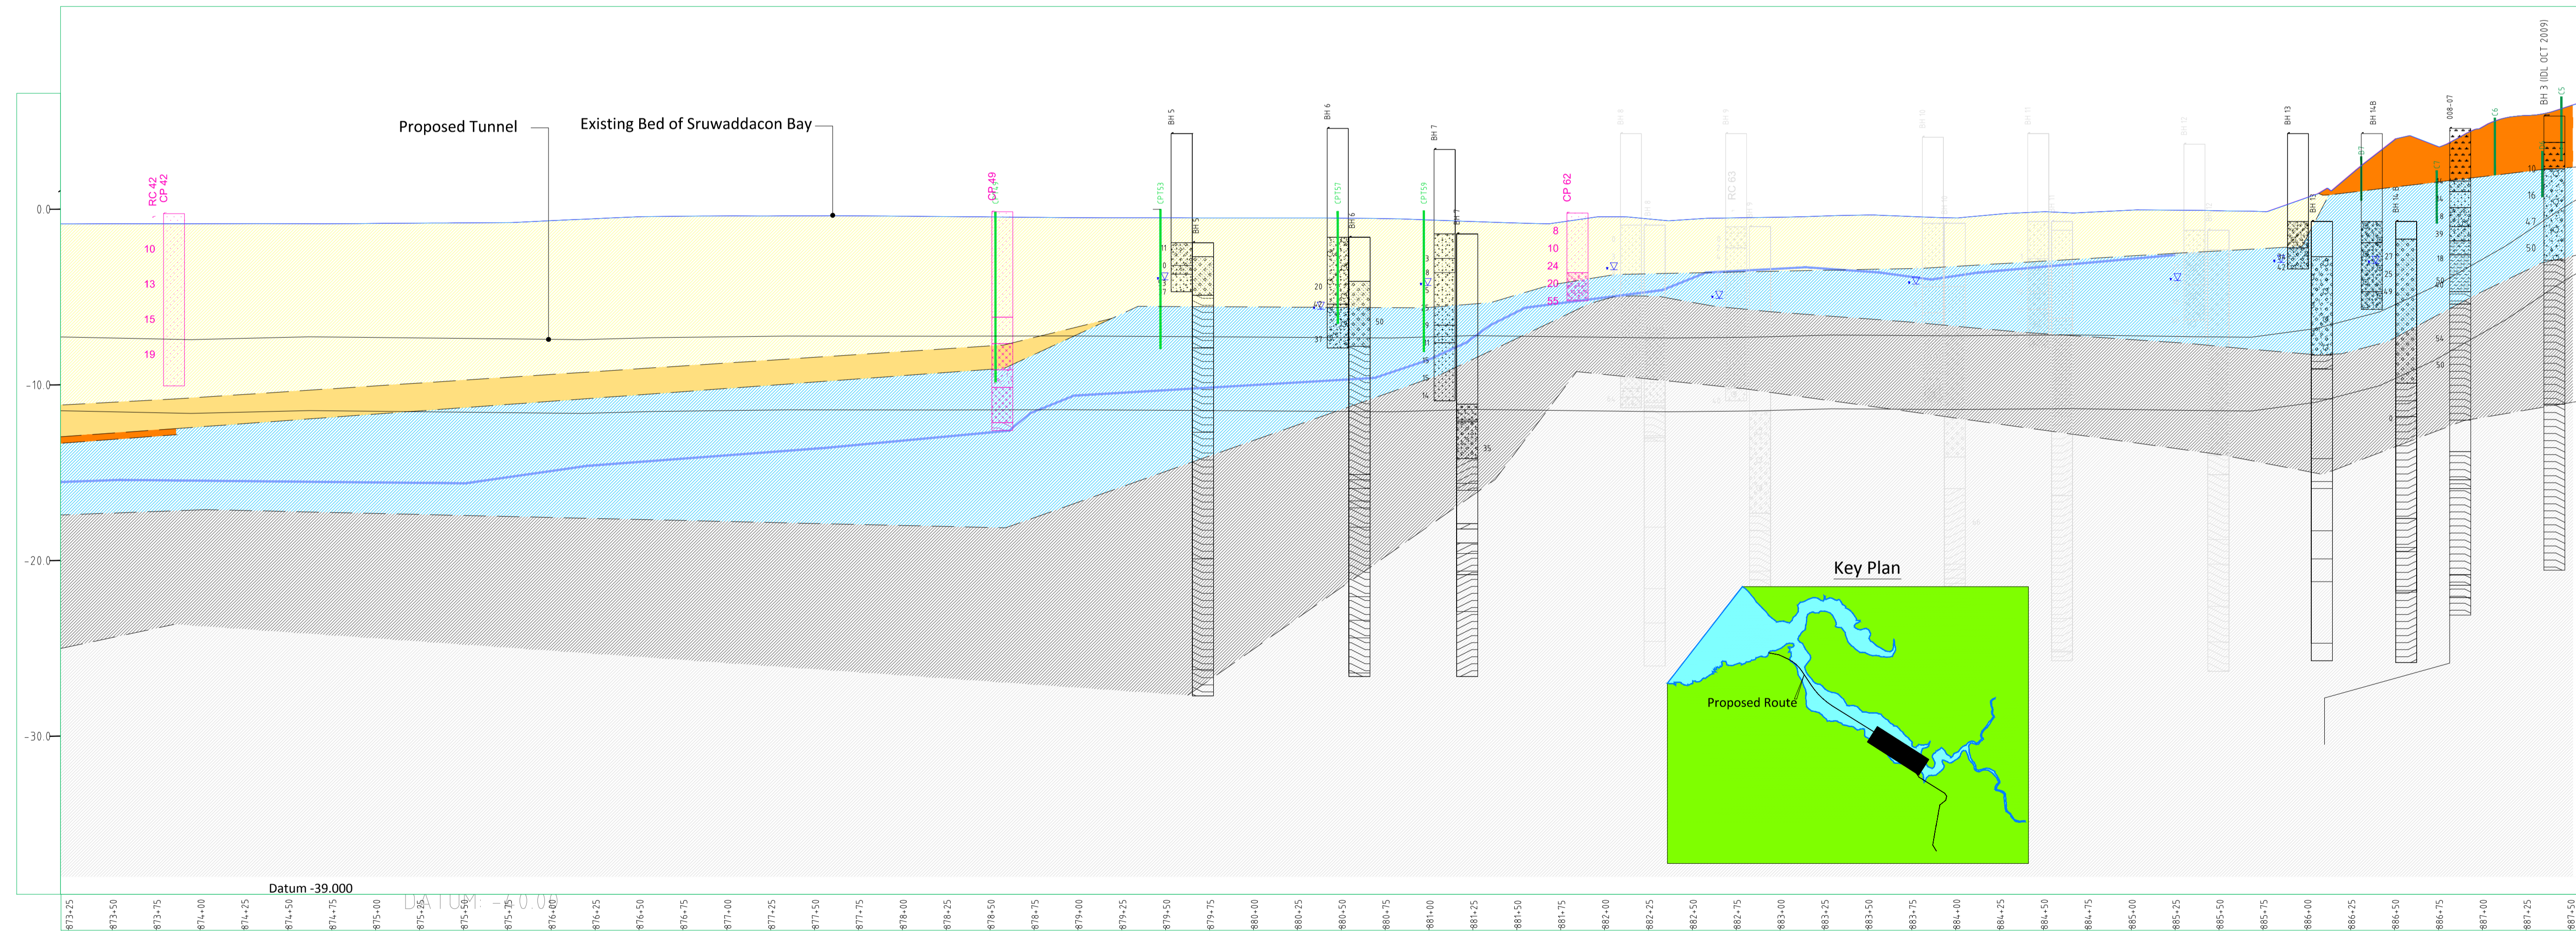

LONGITUDINAL SECTION
Horizontal Scale 1:2000
Vertical Scale 1:200

Applied Ground Engineering Consultants Limited

Further notes:	Notes:	Client:	Job:	Title:	AGEC Ltd The Grainstore Singletons Lane Bagenalstown Carlow Ireland Tel: +353 59 972 3800 Fax: +353 59 972 3793
	1. Geology is Based on Ground Investigation Available at Time of Preparation	Shell E&P Ireland Limited	Corrib Onshore Pipeline		
S:\2010\1045 Corrib Sruwaddacon Bay SI & Geotech Model\CAD\Corrib Baseplan 30.dwg	Scale: 1:8,000 (A1)	Checked: D.B.	www.aged.ie info@aged.ie	Plan and Section Showing Sruwaddacon Geology (Sheet 3 of 3)	
	Date: 19 August 2010	Revision: 0			
	Drawn: P.O.R.	Based on:			